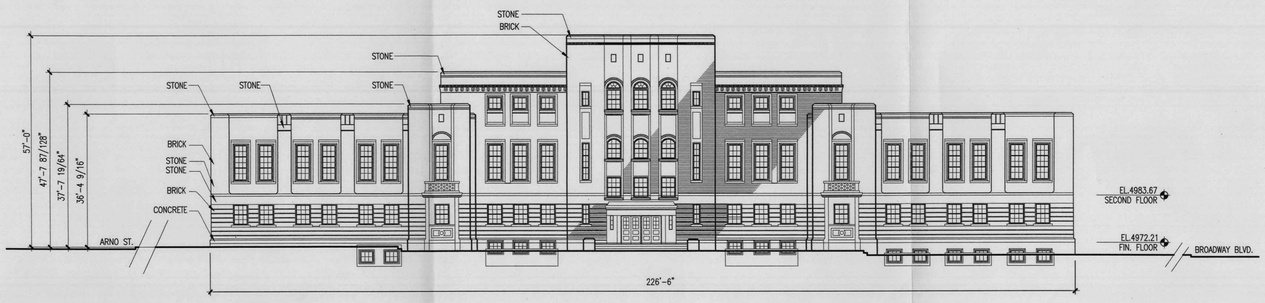

1 Gymnasium - Proposed North Elevation
1/16"=1'-0"
0 4' 8' 16'

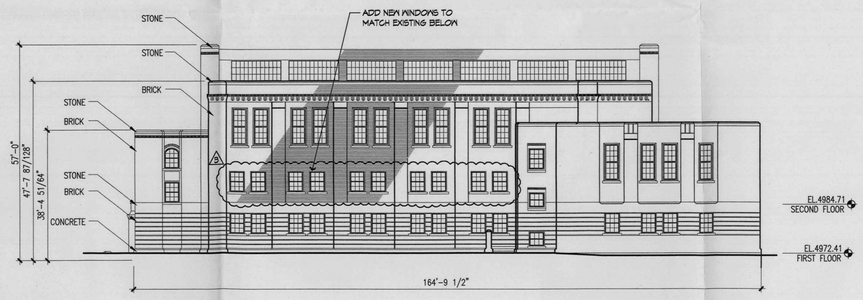

2 Gymnasium - Proposed East Elevation
1/16"=1'-0"
0 4' 8' 16'

3 Gymnasium - Proposed South Elevation
1/16"=1'-0"
0 4' 8' 16'

4 Gymnasium - Proposed West Elevation
1/16"=1'-0"
0 4' 8' 16'

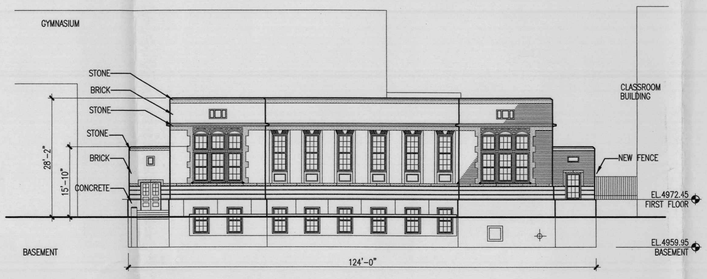

5 Library - Proposed West Elevation
1/16"=1'-0"
0 4' 8' 16'

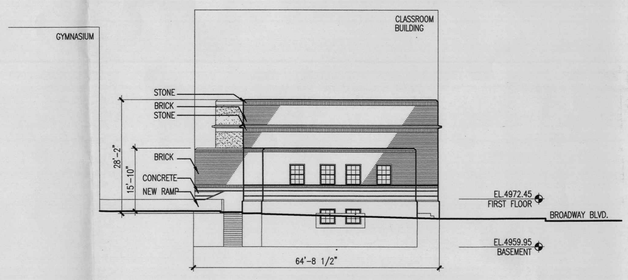

6 Library - Proposed North Elevation
1/16"=1'-0"
0 4' 8' 16'

7 Library - Proposed East Elevation
1/16"=1'-0"
0 4' 8' 16'

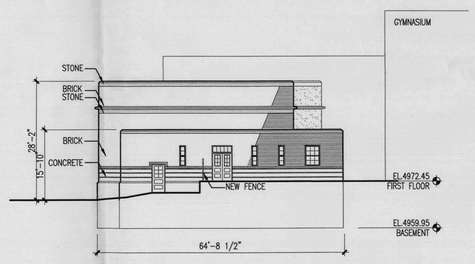

8 Library - Proposed South Elevation
1/16"=1'-0"
0 4' 8' 16'

Note:
* No changes are proposed to existing elevations.
* All dark maroon brick is to remain.
* There are 600+ windows in the four historic buildings of the Old Albuquerque High School campus. The window description is attached. We are in the process of preparing a window survey for the Part II submittal to the State Historic Preservation Office and the National Park Service. That survey will contain detailed information on each window, its current location and a recommendation on restoration or replication/replacement, based on an analysis of that condition.

ADMINISTRATIVE
DEVELOPMENT PLAN
FILE NO. 03 AA-01436
Project 1000184 / Bldg elevations
changes: new window openings
Rick Paulsen 10/8/03
PLANNING DIRECTOR DATE

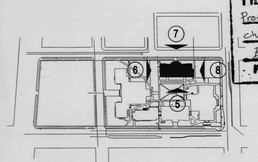

Library - Key Plan
NTS

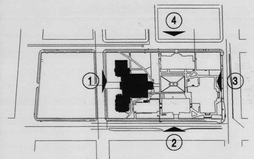

Gymnasium - Key Plan
NTS

architecture
interiors
planning
engineering

Dekker
Perich
Sabatini

6801 Jefferson NE
Suite 100
Albuquerque, NM 87109
505 761-9700
fax 761-4222
dps@dpsabq.com

architect

engineer

PROPOSED

project

Lofts @ Albuquerque High School

Albuquerque, New Mexico

revisions
3 08/13/03 LUCC APPRV. ELEVATIONS

plotted: 07-21-2000 10:48A
Q:\99111_DAVIS\AS BUILT\EPC SUBMITTAL\LIBRARY-ELEV1.D

drawn by	
reviewed by	
date	7-20-00
project no.	99111

drawing name
Gymnasium/ Library
Proposed Elevations

sheet no.
8
of